



RIGHT SIDE ELEVATION



FRONT ELEVATION

REVISIONS	BY

Elise Braceras Stone, Architects
 288 Old Marlboro Road, Concord MA 01746
 (617) 306-0359
 elise@elisebraceras.com

83 MONUMENT ST.
 CONCORD MA
 ELEVATIONS

DRAWN
CHECKED
DATE 1/15/20
SCALE 1/4" = 1'-0"
JOB NO.
SHEET A-4
OF SHEETS



LEFT SIDE ELEVATION




REAR ELEVATION

REVISIONS	BY

Elise Braccas Stone Architects
 288 Old Marlboro Road, Concord MA abstone@comcast.net
 (617) 306-6359

93 MONUMENT ST
 CONCORD MA
 ELEVATIONS

DRAWN
CHECKED
DATE 1/15/26
SCALE 1/4" = 1'-0"
JOB NO.
SHEET A.5
OF SHEETS

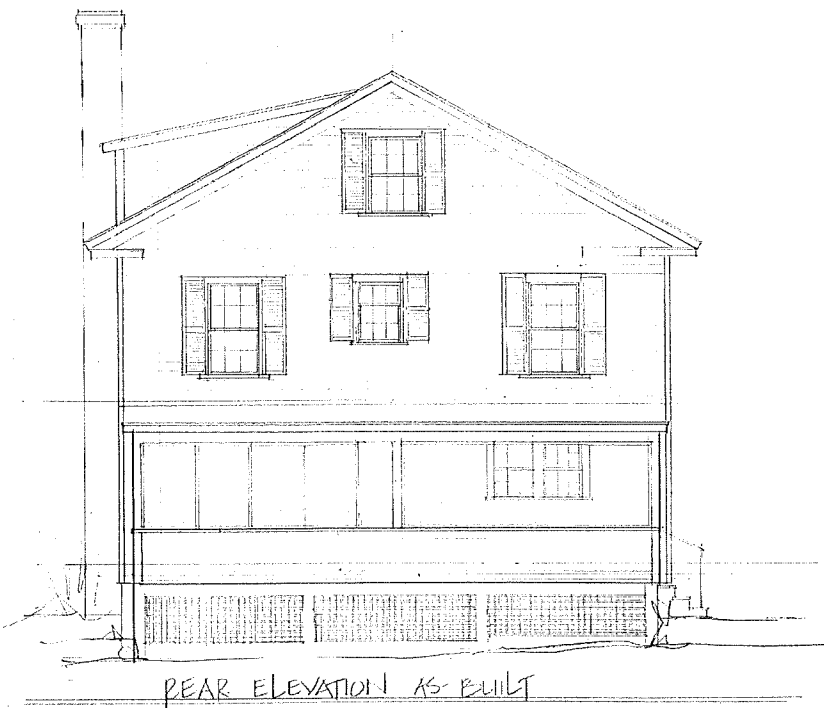

REVISIONS	BY

Elise Braceras Stone, Architects
 288 Old Marlboro Road, Concord MA elstone@comcast.net
 (617) 306-6359


8 1/2 MONUMENT ST.
 CONCORD MA

ELEVATIONS AS BUILT


DRAWN
CHECKED
DATE 1/15/26
SCALE 1/4" = 1'-0"
JOB NO.
SHEET A-7
OF SHEETS




RIGHT SIDE ELEVATION

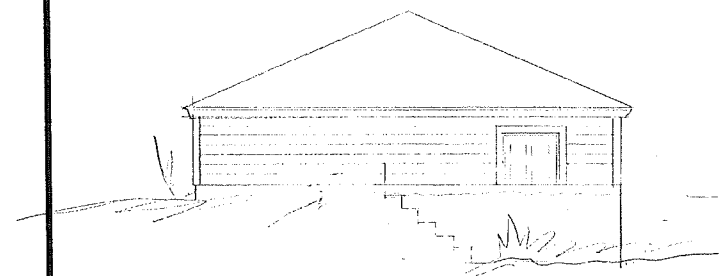

FRONT ELEVATION - BEHIND HOUSE

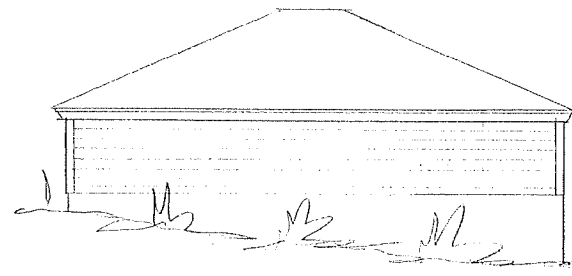

LEFT SIDE ELEVATION

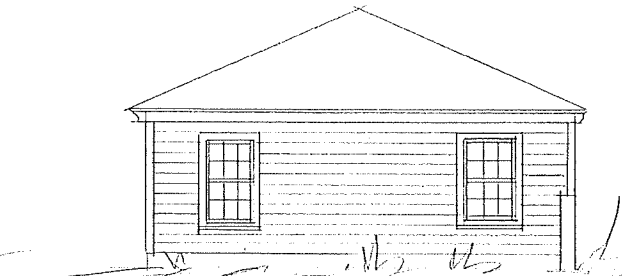

REAR ELEVATION

REVISIONS	BY

Elise Braceras Stone Architects
 288 Old Marlboro Road, Concord MA 03301
 (617) 306-6359
 elbrance@comcast.net

83 MONUMENT ST
 CONCORD MA
 RIGHT SIDE ELEVATION - AS-BUILT

DRAWN
CHECKED
DATE 1/15/26
SCALE 1/4" = 1'-0"
JOB NO.
SHEET A.8
OF SHEETS